

PROJECT DESCRIPTION

PROJECT DESCRIPTION

THIS PROJECT INVOLVES REPLACING THE EXISTING PEDESTRIAN SIGNALS WITH COUNTDOWN PEDESTRIAN SIGNALS, INSTALLING AUDIBLE PUSH BUTTONS, AND INSTALLING VIDEO DETECTION AT THE INTERSECTION OF MD 450 (WEST STREET) AND ADMIRAL DRIVE IN ANNE ARUNDEL COUNTY. THE MODIFICATIONS INVOLVE INSTALLING A NEW BASE-MOUNTED CONTROLLER AND CABINET. MD 450 IS ASSUMED TO RUN IN AN EAST-WEST DIRECTION.

INTERSECTION OPERATION

THE EXISTING PHASING AT THE INTERSECTION WILL REMAIN. THE PHASING OPERATES IN A FOUR-PHASE FULL-TRAFFIC ACTUATED MODE WITH AN ALTERNATE PEDESTRIAN PHASE ACROSS THE EAST LEG OF MD 450 AND A CONCURRENT PHASE ACROSS ADMIRAL DRIVE.

CONTROLLER REQUIREMENTS

INSTALL A FULL-TRAFFIC-ACTUATED, EIGHT-PHASE CONTROLLER WITH ONE (1) FOUR CHANNEL VIDEO DETECTOR RACK, TELEMETRY EQUIPMENT, CONFLICT MONITOR WITH BATTERY BACK-UP, AND ASSOCIATED HARNESSSES HOUSED IN A NEMA '6' BASE MOUNTED CABINET.

EQUIPMENT LIST "A"

A. EQUIPMENT TO BE SUPPLIED BY THE SHA

CATEGORY CODE NO.	QUANTITY	DESCRIPTION
900000	1 EA	VIDEO INTERFACE EQUIPMENT (1-4 CAMERAS)
971017	1 EA	EIGHT-PHASE, FULL-TRAFFIC-ACTUATED, SOLID STATE DIGITAL CONTROLLER WITH SYSTEM PACKAGE AND INTERSECTION MONITOR WITH BATTERY BACK-UP FOR PHONE DROP. HOUSED IN A NEMA SIZE '6' BASE MOUNTED CABINET

EQUIPMENT LIST "B"

B. EQUIPMENT TO BE FURNISHED AND/OR INSTALLED BY THE CONTRACTOR

CATEGORY CODE NO.	SPECIFICATION NUMBER	QUANTITY	DESCRIPTION
585412	549,556	505 LF	12 INCH WHITE LEAD FREE REFLECTIVE THERMOPLASTIC PAVEMENT MARKINGS
585424	549,556	90 LF	24 INCH WHITE LEAD FREE REFLECTIVE THERMOPLASTIC PAVEMENT MARKINGS
800000	800	1 EA	REMOVE AND DISPOSE OF EXISTING FOUNDATION 12 INCHES BELOW GRADE
800000	805	4 EA	16 INCH LED PEDESTRIAN COUNTDOWN SIGNAL HEAD
800000	817	4 EA	AUDIBLE TACTILE PEDESTRIAN PUSH BUTTON & SIGN ASSEMBLY
800000	816	1 EA	FURNISH AND INSTALL CENTRAL CONTROL UNIT 2 WIRE APS
801004	801	6 CY	CONCRETE FOR SIGNAL FOUNDATION
801706	801	8 SF	REMOVE SIGNS FROM EXISTING OVERHEAD STRUCTURE
802501	804	255 LF	NO. 6 AWG STRANDED BARE COPPER GROUND WIRE
805125	805	5 LF	2 INCH SCHEDULE 80 RIGID PVC CONDUIT - TRENCHED
805135	805	115 LF	3 INCH SCHEDULE 80 RIGID PVC CONDUIT - TRENCHED
805140	805	30 LF	4 INCH SCHEDULE 80 RIGID PVC CONDUIT- TRENCHED
807202	807	1 EA	METER SERVICE PEDESTAL
810010	810	5 LF	ELECTRICAL CABLE- 1 CONDUCTOR NO.4 AWG
816001	800	2 EA	VIDEO DETECTION CAMERA
816010	800	2 EA	CONTROL CABLE, 250 FOOT VIDEO DETECTION CAMERA TO CONTROLLER
818004	818,821	4 EA	10 FOOT BREAKAWAY PEDESTAL POLE
837001	810	6 EA	GROUND ROD - 3/4 INCH DIAMETER X 10 FOOT LENGTH
832021	804	5 LF	NO.4 AWG STRANDED BARE COPPER GROUND WIRE
861105	804	440 LF	ELECTRICAL CABLE- 2 CONDUCTOR (NO.14 AWG)
861107	810	560 LF	ELECTRICAL CABLE- 5 CONDUCTOR (NO.14 AWG)
861108	810	450 LF	ELECTRICAL CABLE- 7 CONDUCTOR (NO.14 AWG)
871202	816	1 EA	INSTALL CONTROLLER AND CABINET - BASE MOUNT

PROJECT CONTACTS

THE CONTACT PERSONS FOR SHA ARE AS FOLLOWS:

CONTACTS FOR DISTRICT 5:
MS. KIMBERLY TRAN
ASSISTANT DISTRICT ENGINEER,
TRAFFIC
410-841-1003

MR. ANDRE FUTRELL
ASSISTANT DISTRICT ENGINEER,
MAINTENANCE
410-841-1013

MR. JOHN S. MAYS
UTILITIES ENGINEER
410-841-1039

CONTACTS FOR OFFICE OF
TRAFFIC AND SAFETY:
MR. RICHARD DAFF SR.
CHIEF, TRAFFIC OPERATIONS
410-787-7630

MR. ROBERT SNYDER
ASSISTANT DIVISION CHIEF,
TRAFFIC OPERATIONS
410-787-7630

MR. ED RODENHIZER
CHIEF, SIGNAL OPERATIONS
410-787-7650


MR. EUGENE BAILEY
CHIEF, SIGN OPERATIONS
410-787-7676

MR. MIKE SITOCKER
SIGNAL SHOP WAREHOUSE
410-787-7696

C. EXISTING EQUIPMENT TO BE REMOVED BY THE CONTRACTOR AND DELIVERED TO THE STATE HIGHWAY ADMINISTRATION, 7491 CONNELLEY DRIVE, HANOVER, MARYLAND 21076.

NONE

WIRING DIAGRAM

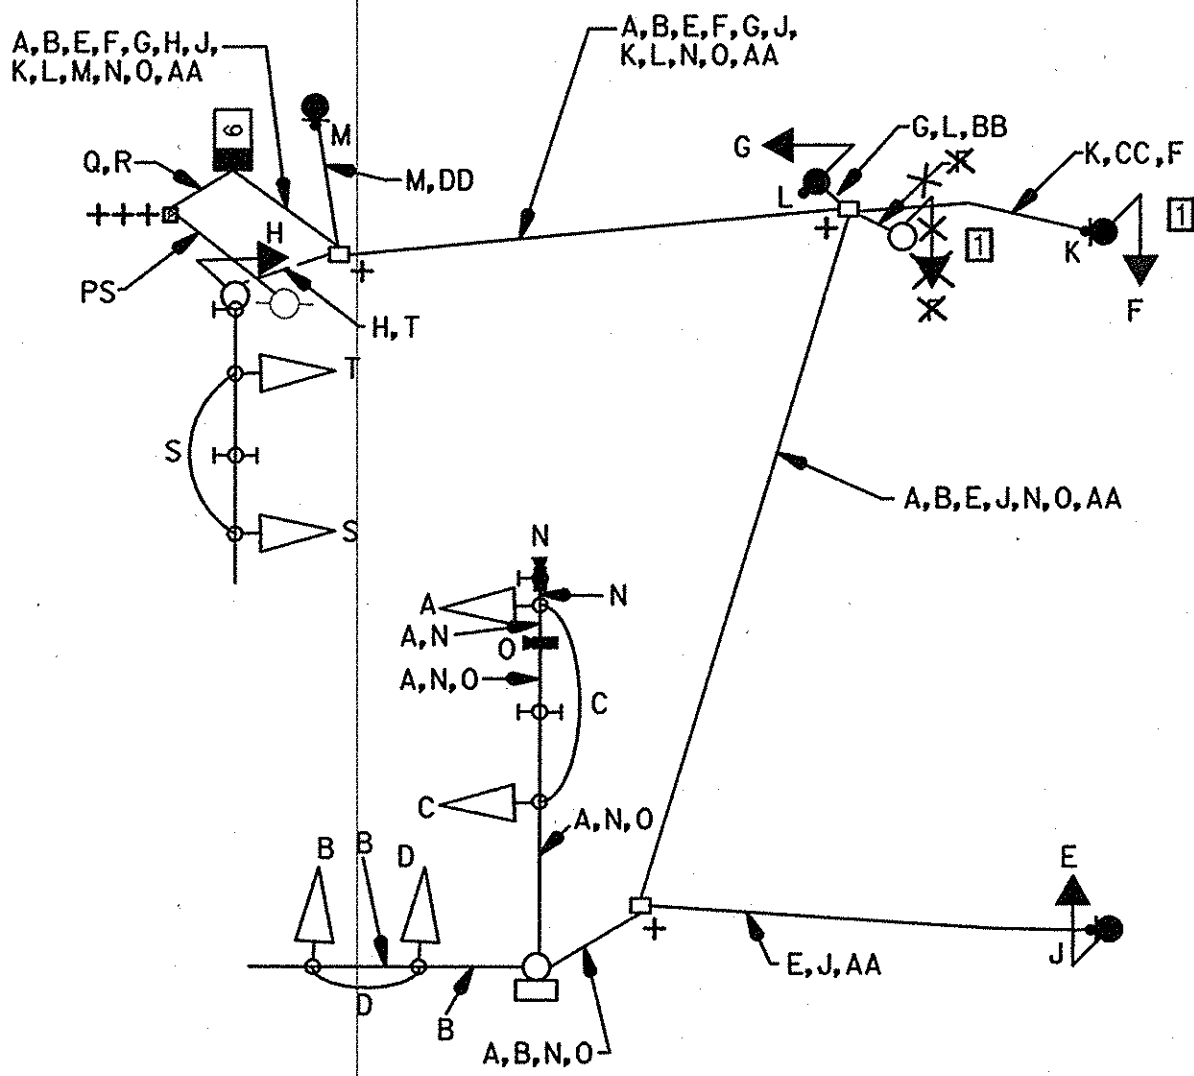

WIRING KEY

A,B	7-CONDUCTOR ELECTRIC CABLE (NO.14 AWG)
C,D,E,F,G,H,S,T	5-CONDUCTOR ELECTRIC CABLE (NO.14 AWG)
J,K,L,M	2-CONDUCTOR ELECTRIC CABLE (NO.14 AWG)
N,O	VIDEO DETECTION LEAD-IN CABLE
Q	NO.4 AWG STRANDED BARE COPPER GROUND WIRE
R	ELECTRICAL CABLE- 1 CONDUCTOR NO.4 AWG
AA,BB,CC,DD	NO.6 AWG STRANDED BARE COPPER GROUND WIRE
PS	POWER SERVICE
+	GROUND ROD

PHASING DIAGRAM

	1	2	3	4	5	6	7	8	9	10
Phase 1 & 6	◀G-G	G	R	R	R	R-G▶	DW	DW	DW	DW
1-6 Change	◀Y-G	G	R	R	R	R-Y▶	DW	DW	DW	DW
Phase 2 & 6	G	G	G	G	R	R	WK	WK	DW	DW
Ped. Clear	G	G	G	G	R	R	FL/DW	FL/DW	DW	DW
2 & 6 Change	Y	Y	Y	Y	R	R	DW	DW	DW	DW
Phase 4	R	R	R	R	G	G	DW	DW	DW	DW
Phase 4 Change	R	R	R	R	Y	Y	DW	DW	DW	DW
Phase 4 Alt.	R	R	R	R	G	G	DW	DW	WK	WK
Ped. Clear	R	R	R	R	G	G	DW	DW	FL/DW	FL/DW
Phase 4 Alt. Change	R	R	R	R	Y	Y	DW	DW	DW	DW
Flashing Operation	FL/Y	FL/Y	FL/Y	FL/Y	FL/R	FL/R	DARK	DARK	DARK	DARK

NOTE: NO CHANGE TO EXISTING OPERATION

12/12/2007
GREENLINE REVISION NO.1 - 12/07
REVISE PEDESTRIAN SIGNAL HEAD LOCATION
REDLINE REVISION NO.1 - 01/07
RELOCATE PROPOSED SIGNAL EQUIPMENT.

REVISION C CONSULTANT
WALLACE, MONTGOMERY & ASSOCIATES, LLP
CIVIL AND STRUCTURAL ENGINEERS
110 West Road, Suite 300
Towson, Maryland 21204
(410) 494-9093, (410) 825-5714 Fax
www.WallaceMontgomery.com

STATE OF MARYLAND
DEPARTMENT OF TRANSPORTATION
STATE HIGHWAY ADMINISTRATION
OFFICE OF TRAFFIC & SAFETY
TRAFFIC ENGINEERING DESIGN DIVISION
**MD 450 (WEST STREET) AT
ADMIRAL DRIVE
ANNAPOLIS, MARYLAND**

GENERAL INFORMATION SHEET

SCALE	NOT TO SCALE	DATE	12/20/06	CONTRACT NO.	AA4495177
DESIGNED BY	J.L.R.	COUNTY	ANNE ARUNDEL		
DRAWN BY	J.L.R./G.N.C.	LOGMILE	02045010.78		
CHECKED BY	M.J.A.	T.I.M.S. NO.	H822		
F.A.P. NO.		T.S. NO.			
DRAWING NO.	TS - 4484C	SHEET NO.	34	OF	37

PLOTTED: Tuesday, December 11, 2007 AT 10:45 AM
FILE: M:\PROJ\203008.06\Cadd\SSG-N002_MD450.dgn